

SHEET 1 OF 7 SHEETS

SCALE: 1" = 500'



RECORD OF SURVEY

IN THE UNINCORPORATED TERRITORY OF THE
COUNTY OF LOS ANGELES, STATE OF CALIFORNIA

BEING A SURVEY OF THE CENTERLINES OF VIDORA DRIVE, VIVERO DRIVE, DUENAS DRIVE, ALBERCA DRIVE, LA CUEVA DRIVE, SORDELLO STREET, LA CORTITA STREET, FARJARDO STREET, BELLORITA STREET, VILLA CLARA STREET, DOUBLETREE LANE, LOS PADRES DRIVE, SIERRA LEONE AVENUE, CAMARINA DRIVE, GALATINA STREET, MESCALERO STREET, & CANELA PLACE

LAWRENCE L. TRUMAN, PLS 5346

Michael Baker

DATE OF SURVEY: AUGUST, 2022

INTERNATIONAL
CONTROL DIAGRAM & CONTROL TABLE

CSRC CORS STATION "LPHS" (LA PUENTE HS)
NORTH LATITUDE = 34°01'36.3643"
WEST LONGITUDE = 117°57'24.1524"
CALIFORNIA STATE PLANE COORDINATE SYSTEM (SPCS) ZONE 5,
NORTH AMERICAN DATUM 1983 (2017.50 EPOCH SOPAC SECTOR
ADJUSTMENT JULY 02, 2017)
NORTHING = 1,832,126.33 US SURVEY FEET
EASTING = 6,574,784.03 US SURVEY FEET
ELLIPSOID HT: 226.97 US SURVEY FEET
COMBINED FACTOR = 0.99999057
CONVERGENCE ANGLE = 00°01'28.83"

CSRC CORS STATION "SPMS" (SOUTH PT MS GRM)
NORTH LATITUDE = 33°59'33.5489"
WEST LONGITUDE = 117°50'55.5498"
CALIFORNIA STATE PLANE COORDINATE SYSTEM (SPCS) ZONE 5,
NORTH AMERICAN DATUM 1983 (2017.50 EPOCH SOPAC SECTOR
ADJUSTMENT JULY 02, 2017)
NORTHING = 1,819,742.71 US SURVEY FEET
EASTING = 6,607,510.56 US SURVEY FEET
ELLIPSOID HT: 681.70 US SURVEY FEET
COMBINED FACTOR = 0.99997644
CONVERGENCE ANGLE = 00°05'10.34"

SURVEYOR'S STATEMENT

D.A. FEE Code 20 \$ 1

THIS MAP CORRECTLY REPRESENTS A SURVEY MADE BY ME OR UNDER MY DIRECTION IN CONFORMANCE WITH THE REQUIREMENTS OF THE PROFESSIONAL LAND SURVEYORS' ACT AT THE REQUEST OF LOS ANGELES COUNTY DEPARTMENT OF PUBLIC WORKS IN JULY 2022.

LAWRENCE L. TRUMAN, P.L.S. 5346

DATE




COUNTY SURVEYOR'S STATEMENT

THIS MAP HAS BEEN EXAMINED IN ACCORDANCE WITH SECTION 8766 OF THE PROFESSIONAL LAND SURVEYORS' ACT, THIS 31st DAY OF JULY, 2023.

DAVID W. FARRELL

DEPUTY COUNTY SURVEYOR

L.S. NO. 7813

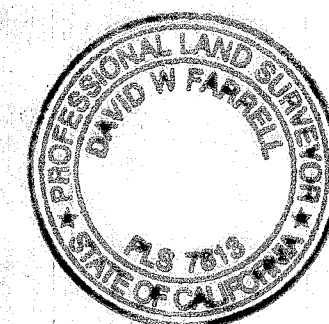

LEGEND OF ABBREVIATIONS

M	=	MEASURED
C.F.	=	CALCULATED FROM
RX	=	RECORD NUMBER
Q	=	CENTERLINE
COH	=	CALIFORNIA ORTHOMETRIC HEIGHT
COMB.	=	COMBINATION
CSRC	=	CALIFORNIA SPATIAL REFERENCE CENTER
CO.	=	COUNTY
H.H.	=	HAND HOLE
HT	=	HEIGHT
LAT.	=	LATITUDE
LONG	=	LONGITUDE
MON.	=	MONUMENT
C.E.F.B.	=	COUNTY ENGINEERS FIELD BOOK
C.S.F.B.	=	COUNTY SURVEYORS FIELD BOOK
S.B.M.	=	SAN BERNARDINO MERIDIAN
T	=	TOWNSHIP
R	=	RANGE
SEC	=	SECTION
N	=	NORTH
S	=	SOUTH
E	=	EAST
W	=	WEST
SPN	=	SEARCHED FOUND NOTHING
SUR.	=	SURVEYOR

ACCURACY STATEMENT:

THE DATA AND MEASUREMENTS SHOWN HEREON ARE DERIVED FROM A FIELD SURVEY PERFORMED USING A COMBINATION OF THE FOLLOWING INSTRUMENTS/METHODS: (TRIMBLE S7 TOTAL STATION (1" STANDARD DEVIATION) (0.3 MGN) (1 MM + 2 PPM) (0.003 FT. + 2 PPM), STATIC GNSS SURVEY PERFORMED WITH A TRIMBLE R10 GNSS SYSTEM (HORIZONTAL 3 MM + 0.5 PPM RMS), AND ELECTRONIC DIFFERENTIAL LEVELING PERFORMED WITH A TRIMBLE DINI DIGITAL LEVEL (1.0 MM STANDARD DEVIATION PER 1 KM).

SAID FIELD DATA WAS INCORPORATED INTO A CORRECTLY WEIGHTED FULLY CONSTRAINED LEAST SQUARES CONTROL NETWORK ADJUSTMENT PERFORMED USING TRIMBLE BUSINESS CENTER V5.60 AND STARNET V11 SOFTWARE. THE RESULTS OF SAID ADJUSTMENT PRODUCED AN AVERAGE LENGTH OF 0.033' FOR THE SEMI-MAJOR AXIS OF THE ERROR ELLIPSE EXPRESSED IN FEET AT THE 95% CONFIDENCE LEVEL. THIS REPRESENTS THE UNCERTAINTY DUE TO RANDOM ERRORS IN THE MEASUREMENTS OF THE LOCATIONS OF THE MONUMENTS AND WITNESS MARKERS USED FOR THE ESTABLISHMENT OF THE CENTERLINE ALIGNMENTS SHOWN HEREON.

STATEMENT OF PURPOSE

THE PURPOSE OF THIS SURVEY IS TO LOCATE EXISTING MONUMENTS AND RETRACE CENTERLINES PURSUANT TO THE BUSINESS AND PROFESSIONS CODE, CHAPTER 15, SECTIONS 8762 AND 8771 OF THE PROFESSIONAL LAND SURVEYOR'S ACT ALONG THE CENTERLINES OF VIDORA DRIVE, VIVERO DRIVE, DUENAS DRIVE, ALBERCA DRIVE, LA CUEVA DRIVE, SORDELLO STREET, LA CORTITA STREET, FARJARDO STREET, BELLORITA STREET, VILLA CLARA STREET, DOUBLETREE LANE, LOS PADRES DRIVE, SIERRA LEONE AVENUE, CAMARINA DRIVE, GALATINA STREET, MESCALERO STREET, & CANELA PLACE.

SURVEYORS NOTES

ALL DISTANCE SHOWN ON SHEET 1 ARE GRID DISTANCES, ALL DISTANCES SHOWN ON SHEETS 3 THROUGH 6 ARE GROUND DISTANCES.

BENCHMARK


THE BASIS OF ELEVATIONS FOR THIS SURVEY IS THE NORTH AMERICAN VERTICAL DATUM OF 1988 (NAVD88) PER LOS ANGELES COUNTY DEPARTMENT OF PUBLIC WORKS, OTTERBEIN QUAD, 2013 ADJUSTMENT. BENCHMARK DESIGNATION: G 2615, CITY OF INDUSTRY DISC IN S CB 1FT W/O BCR @ SE CORNER COLIMA ROAD & JELICK AVENUE INT MAKD (BENCH MARK 5-9), HAVING A PUBLISHED ELEVATION OF 465.386' FEET (NAVD88).

GRID CONTROL TO GRID MONUMENTATION TABLE

POINT LPHS TO:	POINT SPMS TO:
POINT 652 - N42°35'03"W [23149.54'] TIE ONLY	POINT 652 - N74°43'14"E [17687.08'] TIE ONLY
POINT 654 - N43°45'06"W [22713.76'] TIE ONLY	POINT 654 - N76°41'56"E [17488.31'] TIE ONLY
POINT 656 - N44°58'38"W [22489.06'] TIE ONLY	POINT 656 - N78°10'18"E [17195.79'] TIE ONLY
POINT 1003 - N47°32'08"W [23429.69'] TIE ONLY	POINT 1003 - N77°27'40"E [15819.83'] TIE ONLY
POINT 1037 - N45°55'28"W [25736.63'] TIE ONLY	POINT 1037 - N68°48'40"E [15269.01'] TIE ONLY

GRID CONTROL TABLE VALUES

POINT	NORTHING	EASTING	ELEVATION (NAVD88)	DESCRIPTION
LPHS	1832126.33	6574784.03	---	LA PUENTE HS
SPMS	1819742.71	6607510.56	---	SOUTH POINT MS GRM
652	1815081.68	6590448.68	506.95'	FOUND STD LACO RD MONUMENT, IN WELL, DN. 0.5', ACCEPTED AS S&T PER R3.
654	1815719.20	6590491.38	501.16'	FOUND SPIKE & TAG, ILLEGIBLE, DN. 0.3', ACCEPTED AS S&T PER R3.
656	1816217.88	6590679.91	493.09'	FOUND SPIKE & TAG, ILLEGIBLE, DN. 0.4', ACCEPTED AS S&T PER R3.
1003	1816308.20	6592068.05	483.08'	FOUND SPIKE, DN. 0.1', ACCEPTED AS S&T PER R4.
1037	1814223.79	6593273.84	536.82'	FOUND SPIKE & TAG, ILLEGIBLE, DN. 0.3', ACCEPTED AS S&T PER R2.

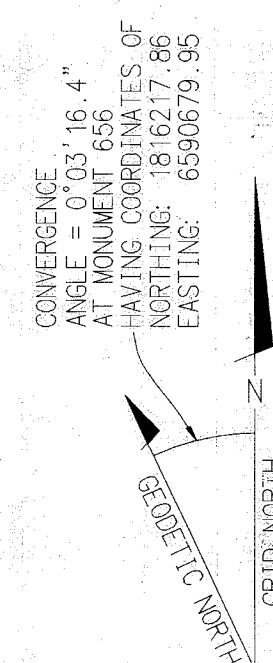CONVERGENCE ANGLE
CONTROL DIAGRAM N.T.S.

RECORD REFERENCES

SEE SHEET 7

MONUMENT & ESTABLISHMENT NOTES

SEE SHEET 7

MONUMENT NOTES

● INDICATES FOUND CENTERLINE MONUMENT AS NOTED AND REFERENCED.

▲ INDICATES PUBLISHED CSRC STATION MONUMENT AS NOTED.

BASIS OF BEARINGS

(PURSUANT TO THE CALIFORNIA PUBLIC RESOURCE CODE, SECTIONS 8801-8819)

THE BEARINGS AND COORDINATES SHOWN HEREIN ARE BASED ON THE CALIFORNIA COORDINATE SYSTEM OF 1983 (CCS83), ZONE V, 2017.50 EPOCH AND WERE DETERMINED BY GLOBAL NAVIGATION SATELLITE SYSTEM (G.N.S.S.) TIES TO TWO CALIFORNIA SPATIAL REFERENCE NETWORK (C.S.R.N.) STATIONS REFERRED TO AS LPHS AND SPMS.

THE CCS83 GRID BEARING BETWEEN C.S.R.N. STATIONS LPHS AND SPMS BEING NORTH 69°16'25" WEST, AS DERIVED FROM THE POSITIONS FOR SAID STATIONS, IN SAID EPOCH, PUBLISHED BY THE CALIFORNIA SPATIAL REFERENCE CENTER (C.S.R.C.) ON MARCH 1, 2018, WAS USED AS THE BASIS OF BEARINGS FOR THIS SURVEY.

ALL VALUES ARE EXPRESSED IN U.S. SURVEY FEET
(1 FOOT = 1200/3937 METERS)

ALL COORDINATES SHOWN HEREON ARE GRID. ALL MEASURED DISTANCES SHOWN HEREIN ARE GROUND DISTANCES UNLESS INDICATED OTHERWISE. GRID DISTANCES ARE SHOWN AS [XXX.XX']. TO OBTAIN GRID DISTANCES WHERE NOT SHOWN, MULTIPLY GROUND DISTANCES BY A PROJECT SPECIFIC COMBINED SCALE FACTOR OF 0.99999312.

SHEET 2 OF 7 SHEETS

SCALE: NONE


RECORD OF SURVEY

IN THE UNINCORPORATED TERRITORY OF THE
COUNTY OF LOS ANGELES, STATE OF CALIFORNIABEING A SURVEY OF THE CENTERLINES OF VIDORA DRIVE, VIVERO DRIVE, DUENAS DRIVE, ALBERCA DRIVE, LA CUEVA DRIVE, SORDELLO
STREET, LA CORTITA STREET, FARJARDO STREET, BELLORITA STREET, VILLA CLARA STREET, DOUBLETREE LANE, LOS PADRES DRIVE, SIERRA
LEONE AVENUE, CAMARINA DRIVE, GALATINA STREET, MESCALERO STREET, & CANELA PLACE

LAWRENCE L. TRUMAN, PLS 5346

Michael Baker

DATE OF SURVEY: AUGUST, 2022

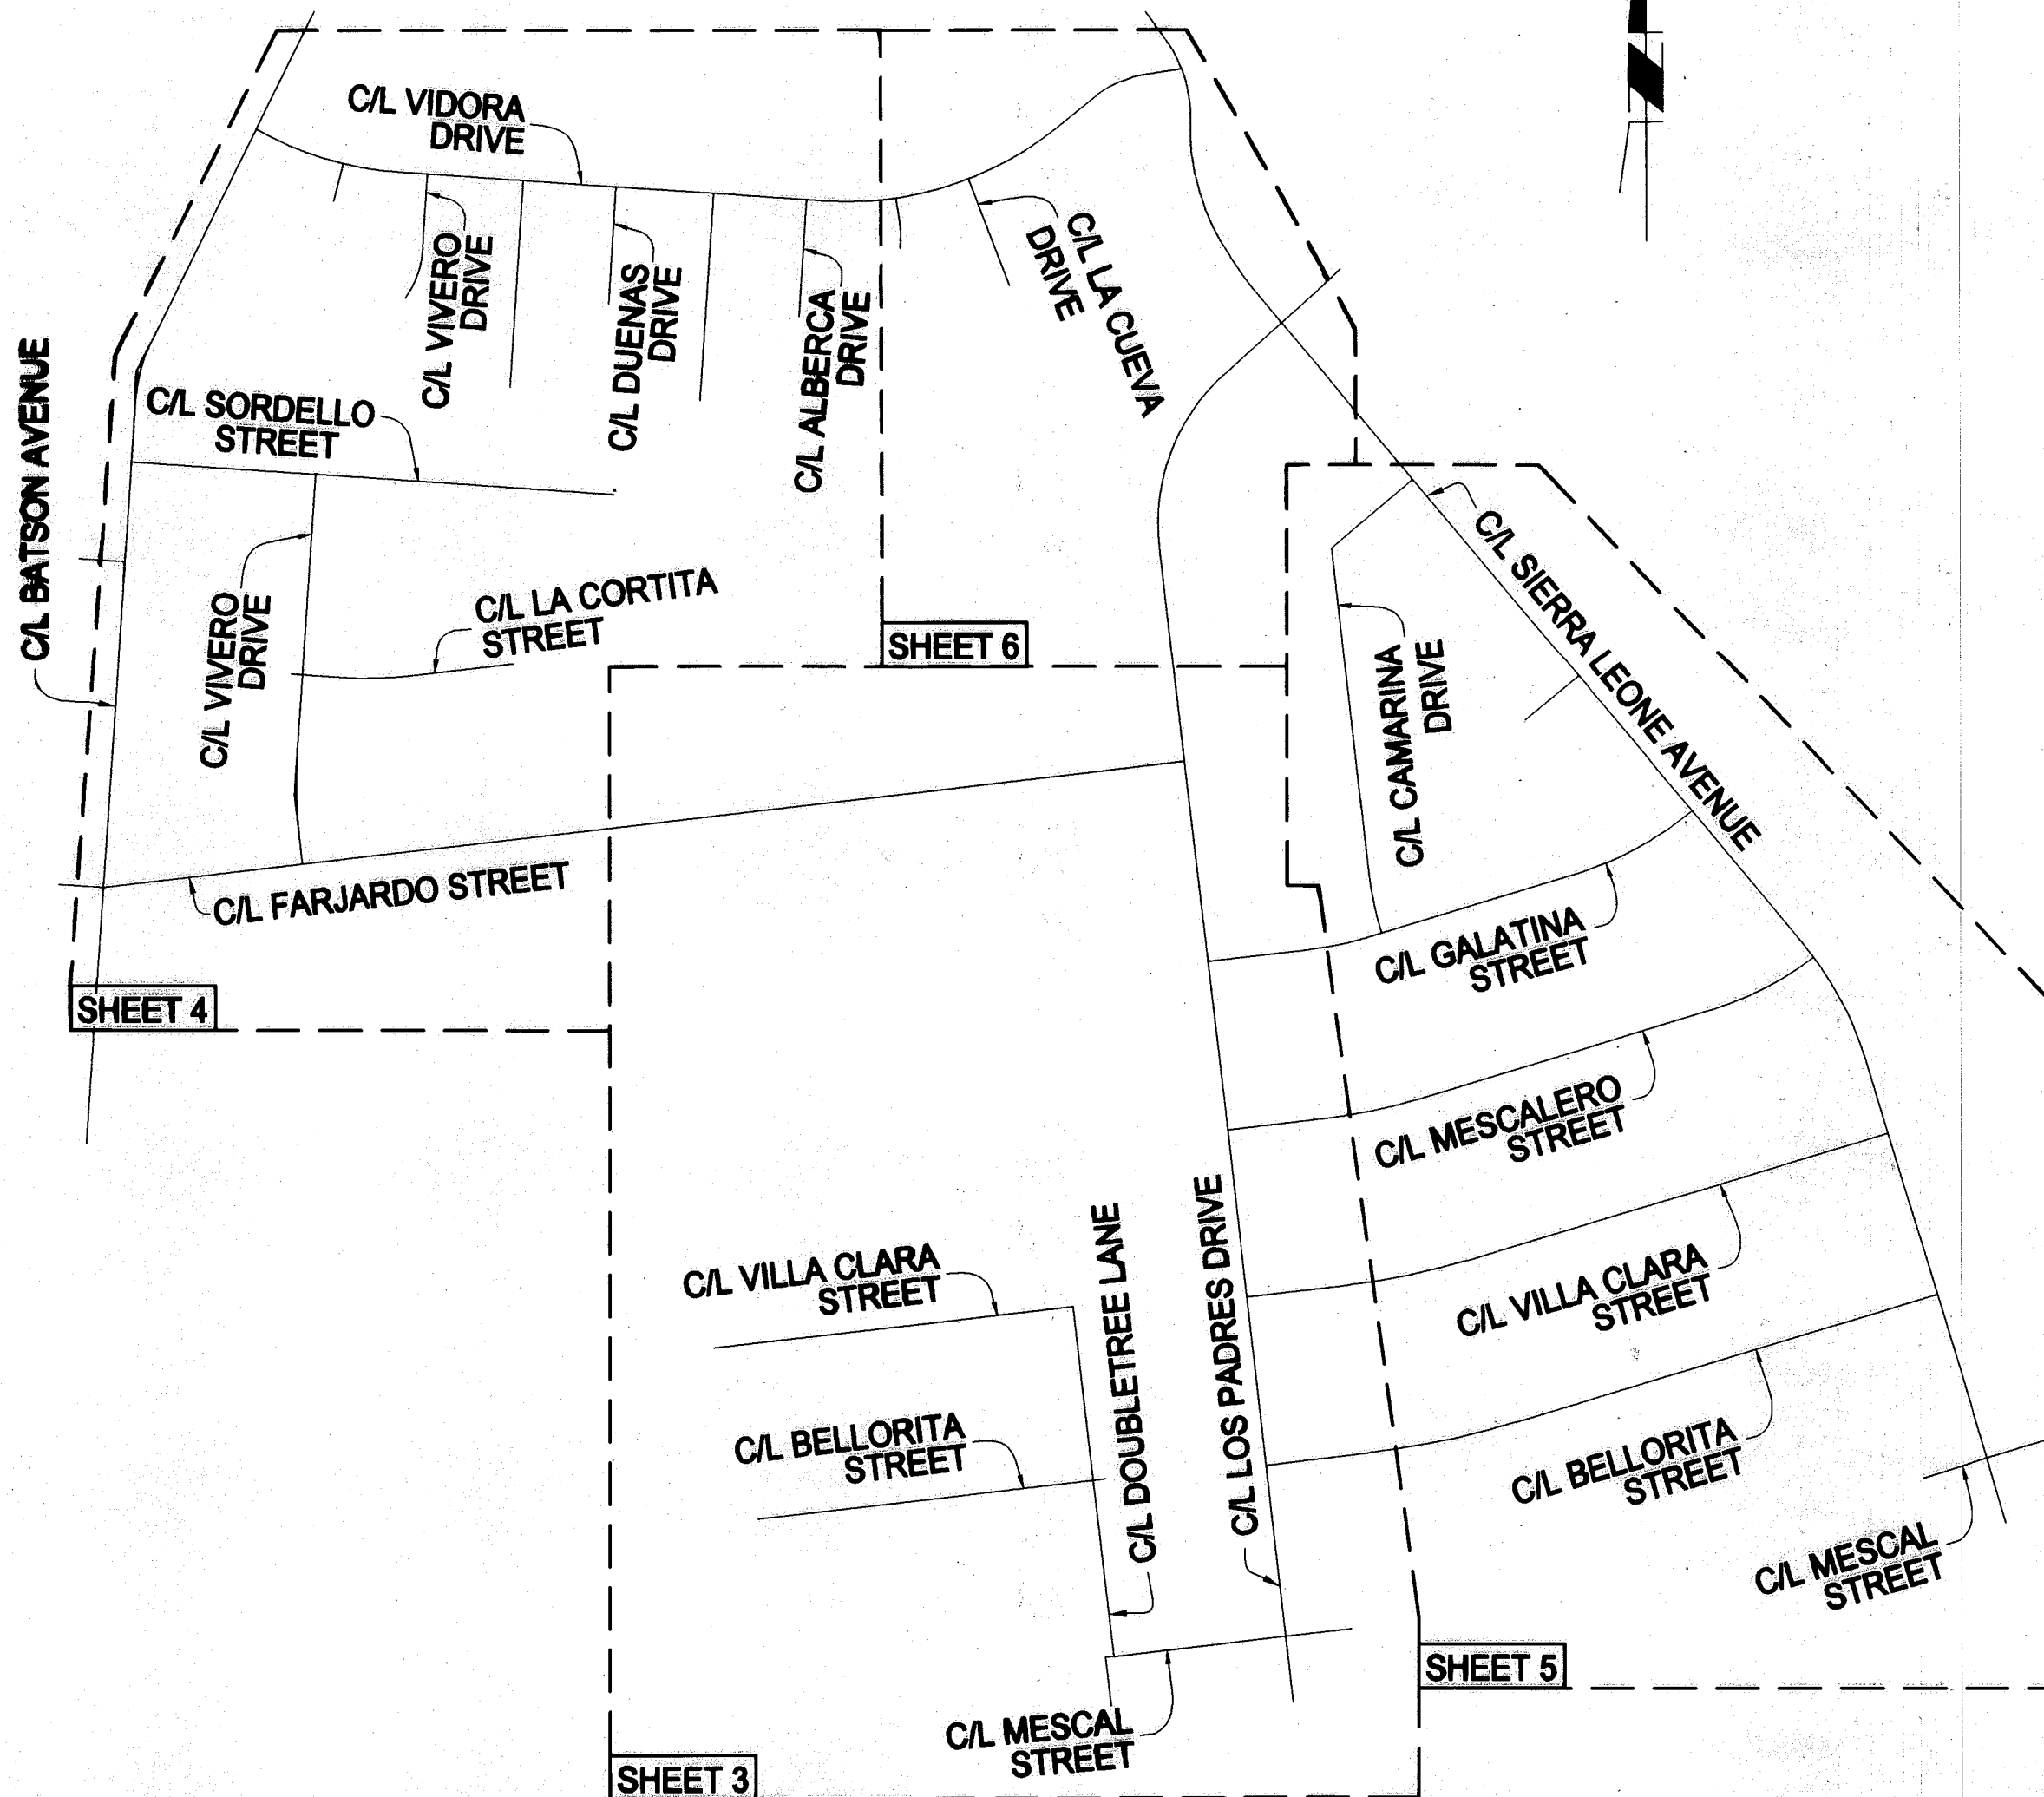INTERNATIONALKEY MAP
NO SCALE

SHEET 3 OF 7 SHEETS

SCALE: 1" = 80'

RECORD OF SURVEY


IN THE UNINCORPORATED TERRITORY OF THE
COUNTY OF LOS ANGELES, STATE OF CALIFORNIA

BEING A SURVEY OF THE CENTERLINES OF VIDORA DRIVE, VIVERO DRIVE, DUENAS DRIVE, ALBERCA DRIVE, LA CUEVA DRIVE, SORDELLO STREET, LA CORTITA STREET, FARJARD STREET, BELLORITA STREET, VILLA CLARA STREET, DOUBLETREE LANE, LOS PADRES DRIVE, SIERRA LEONE AVENUE, CAMARINA DRIVE, GALATINA STREET, MESCALERO STREET, & CANELA PLACE

LAWRENCE L. TRUMAN, PLS 5346

Michael Baker

DATE OF SURVEY: AUGUST, 2022

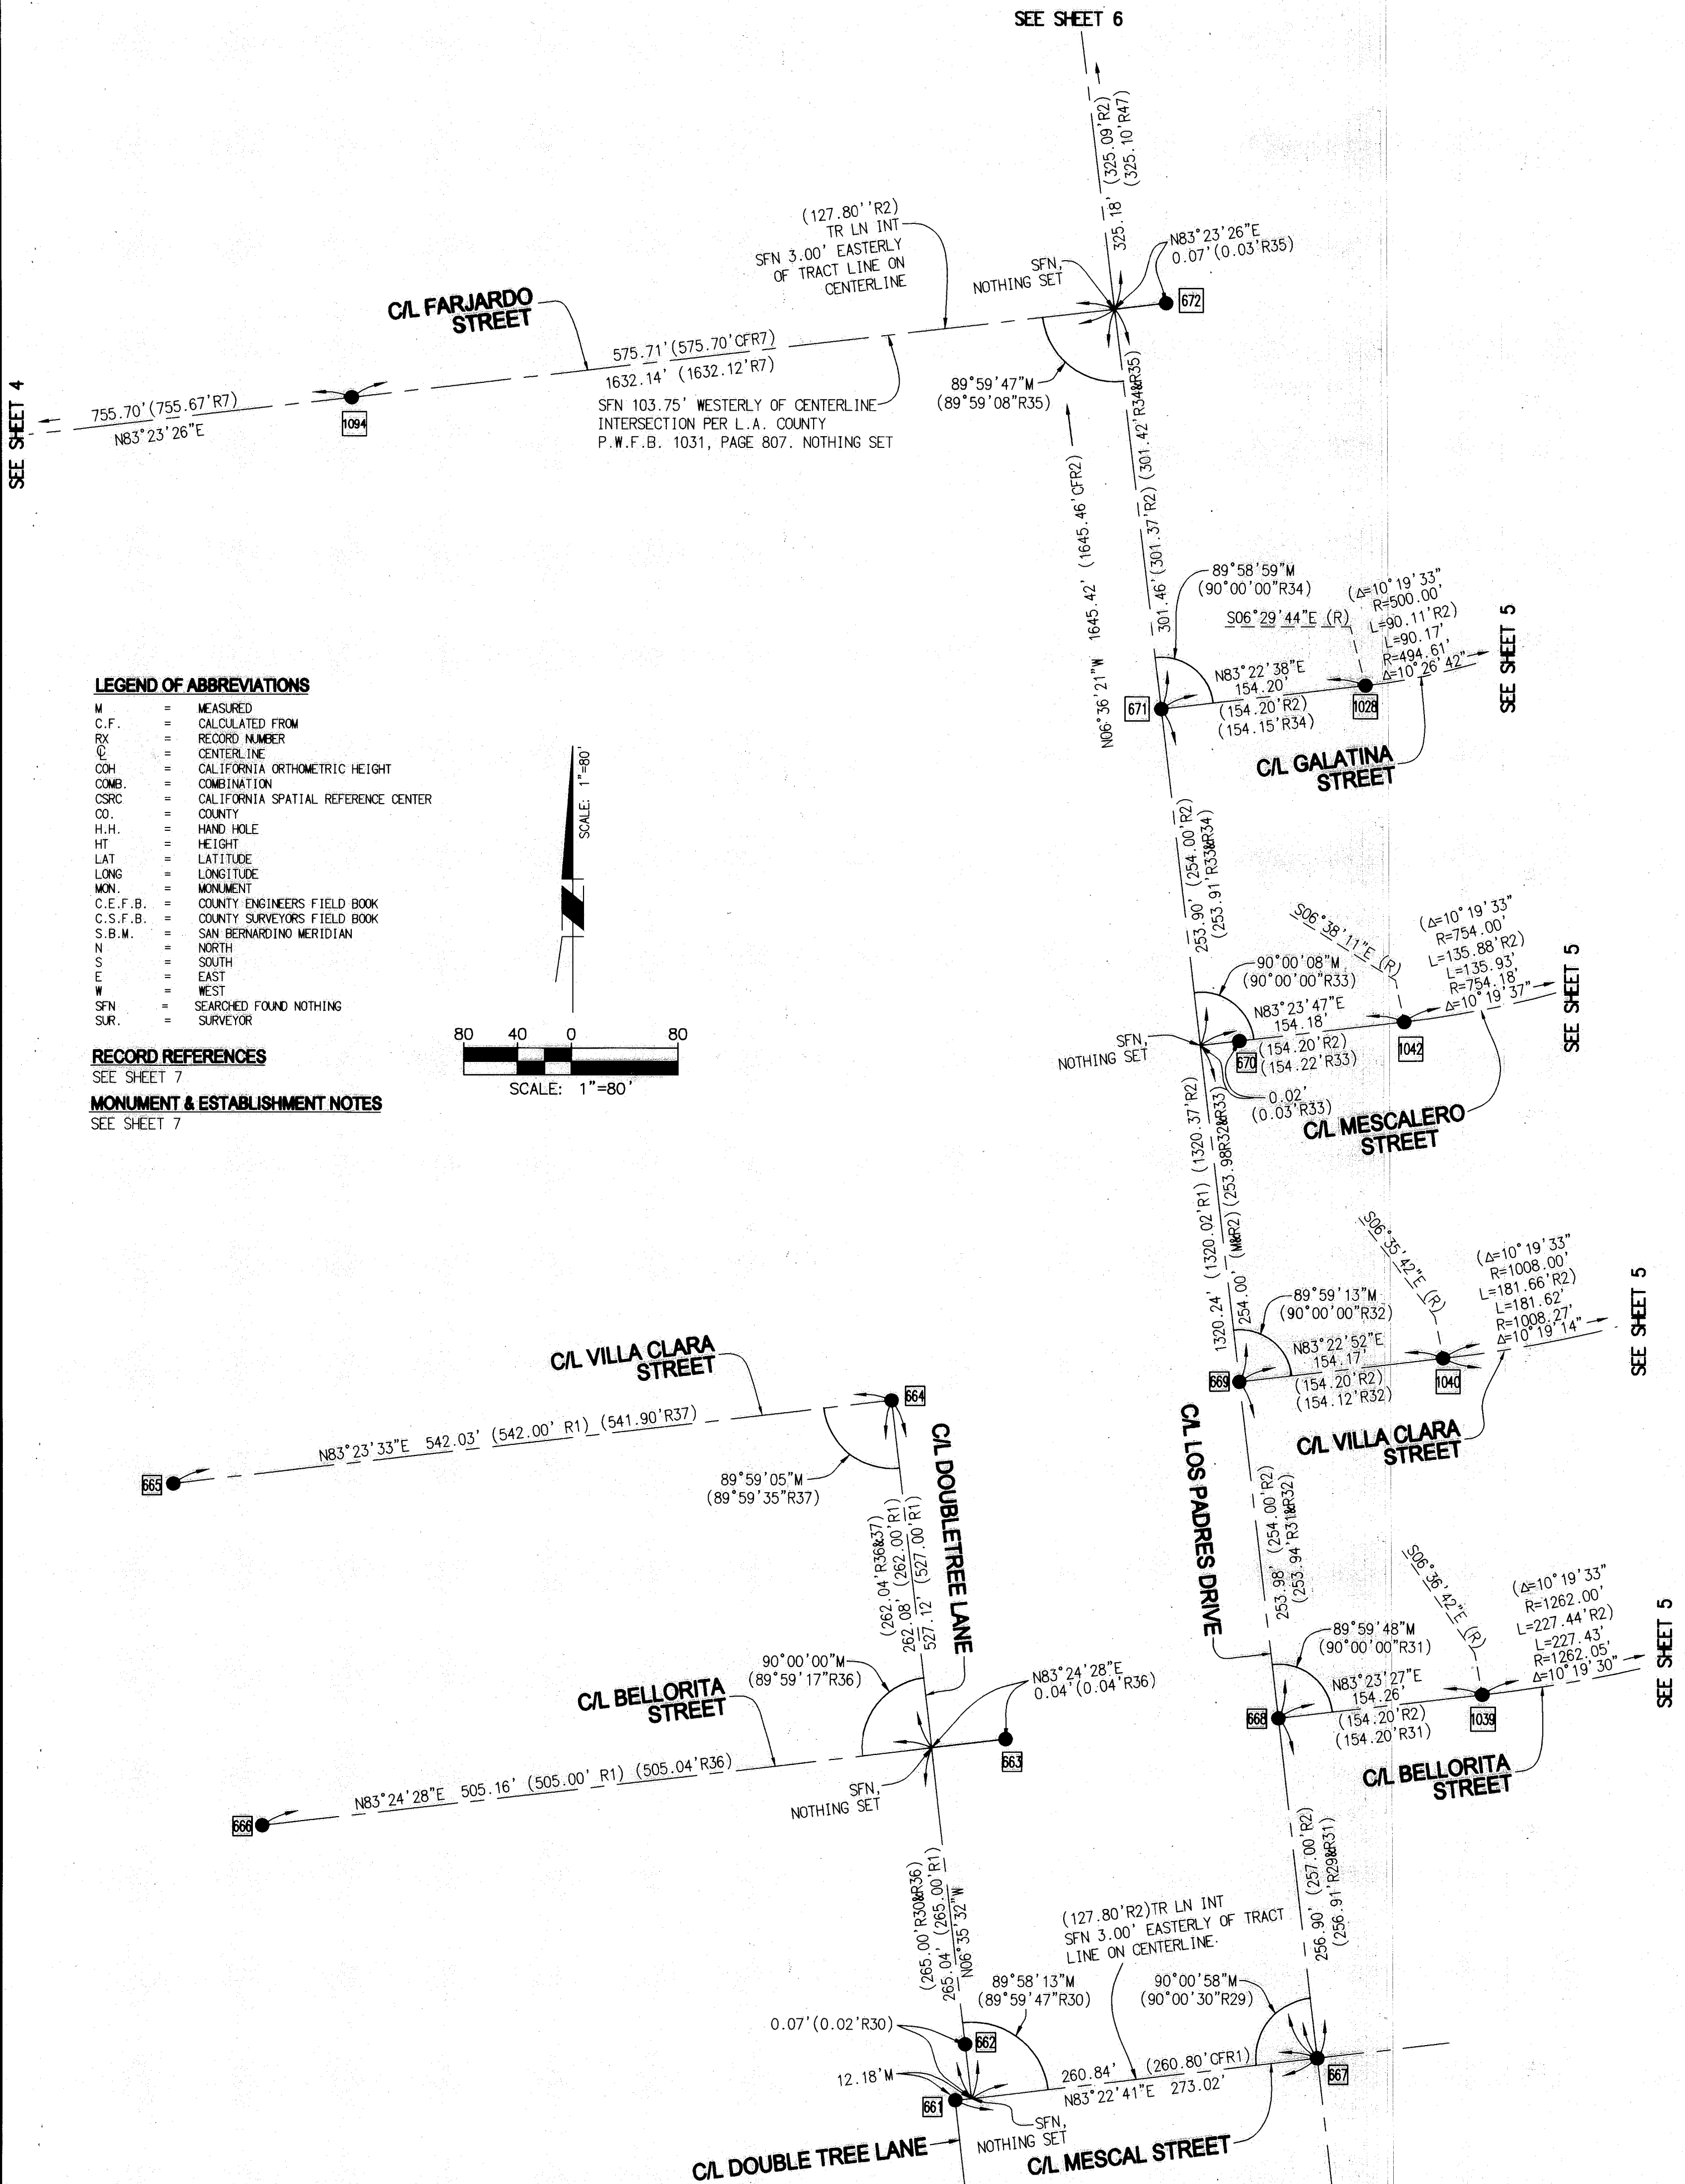INTERNATIONAL

SHEET 4 OF 7 SHEETS

SCALE: 1" = 80'

RECORD OF SURVEY


IN THE UNINCORPORATED TERRITORY OF THE
COUNTY OF LOS ANGELES, STATE OF CALIFORNIA

BEING A SURVEY OF THE CENTERLINES OF VIDORA DRIVE, VIVERO DRIVE, DUENAS DRIVE, ALBERCA DRIVE, LA CUEVA DRIVE, SORDELLO STREET, LA CORTITA STREET, FARJARDO STREET, BELLORITA STREET, VILLA CLARA STREET, DOUBLETREE LANE, LOS PADRES DRIVE, SIERRA LEONE AVENUE, CAMARINA DRIVE, GALATINA STREET, MESCALERO STREET, & CANELA PLACE

LAWRENCE L. TRUMAN, PLS 5346

Michael Baker

DATE OF SURVEY: AUGUST, 2022

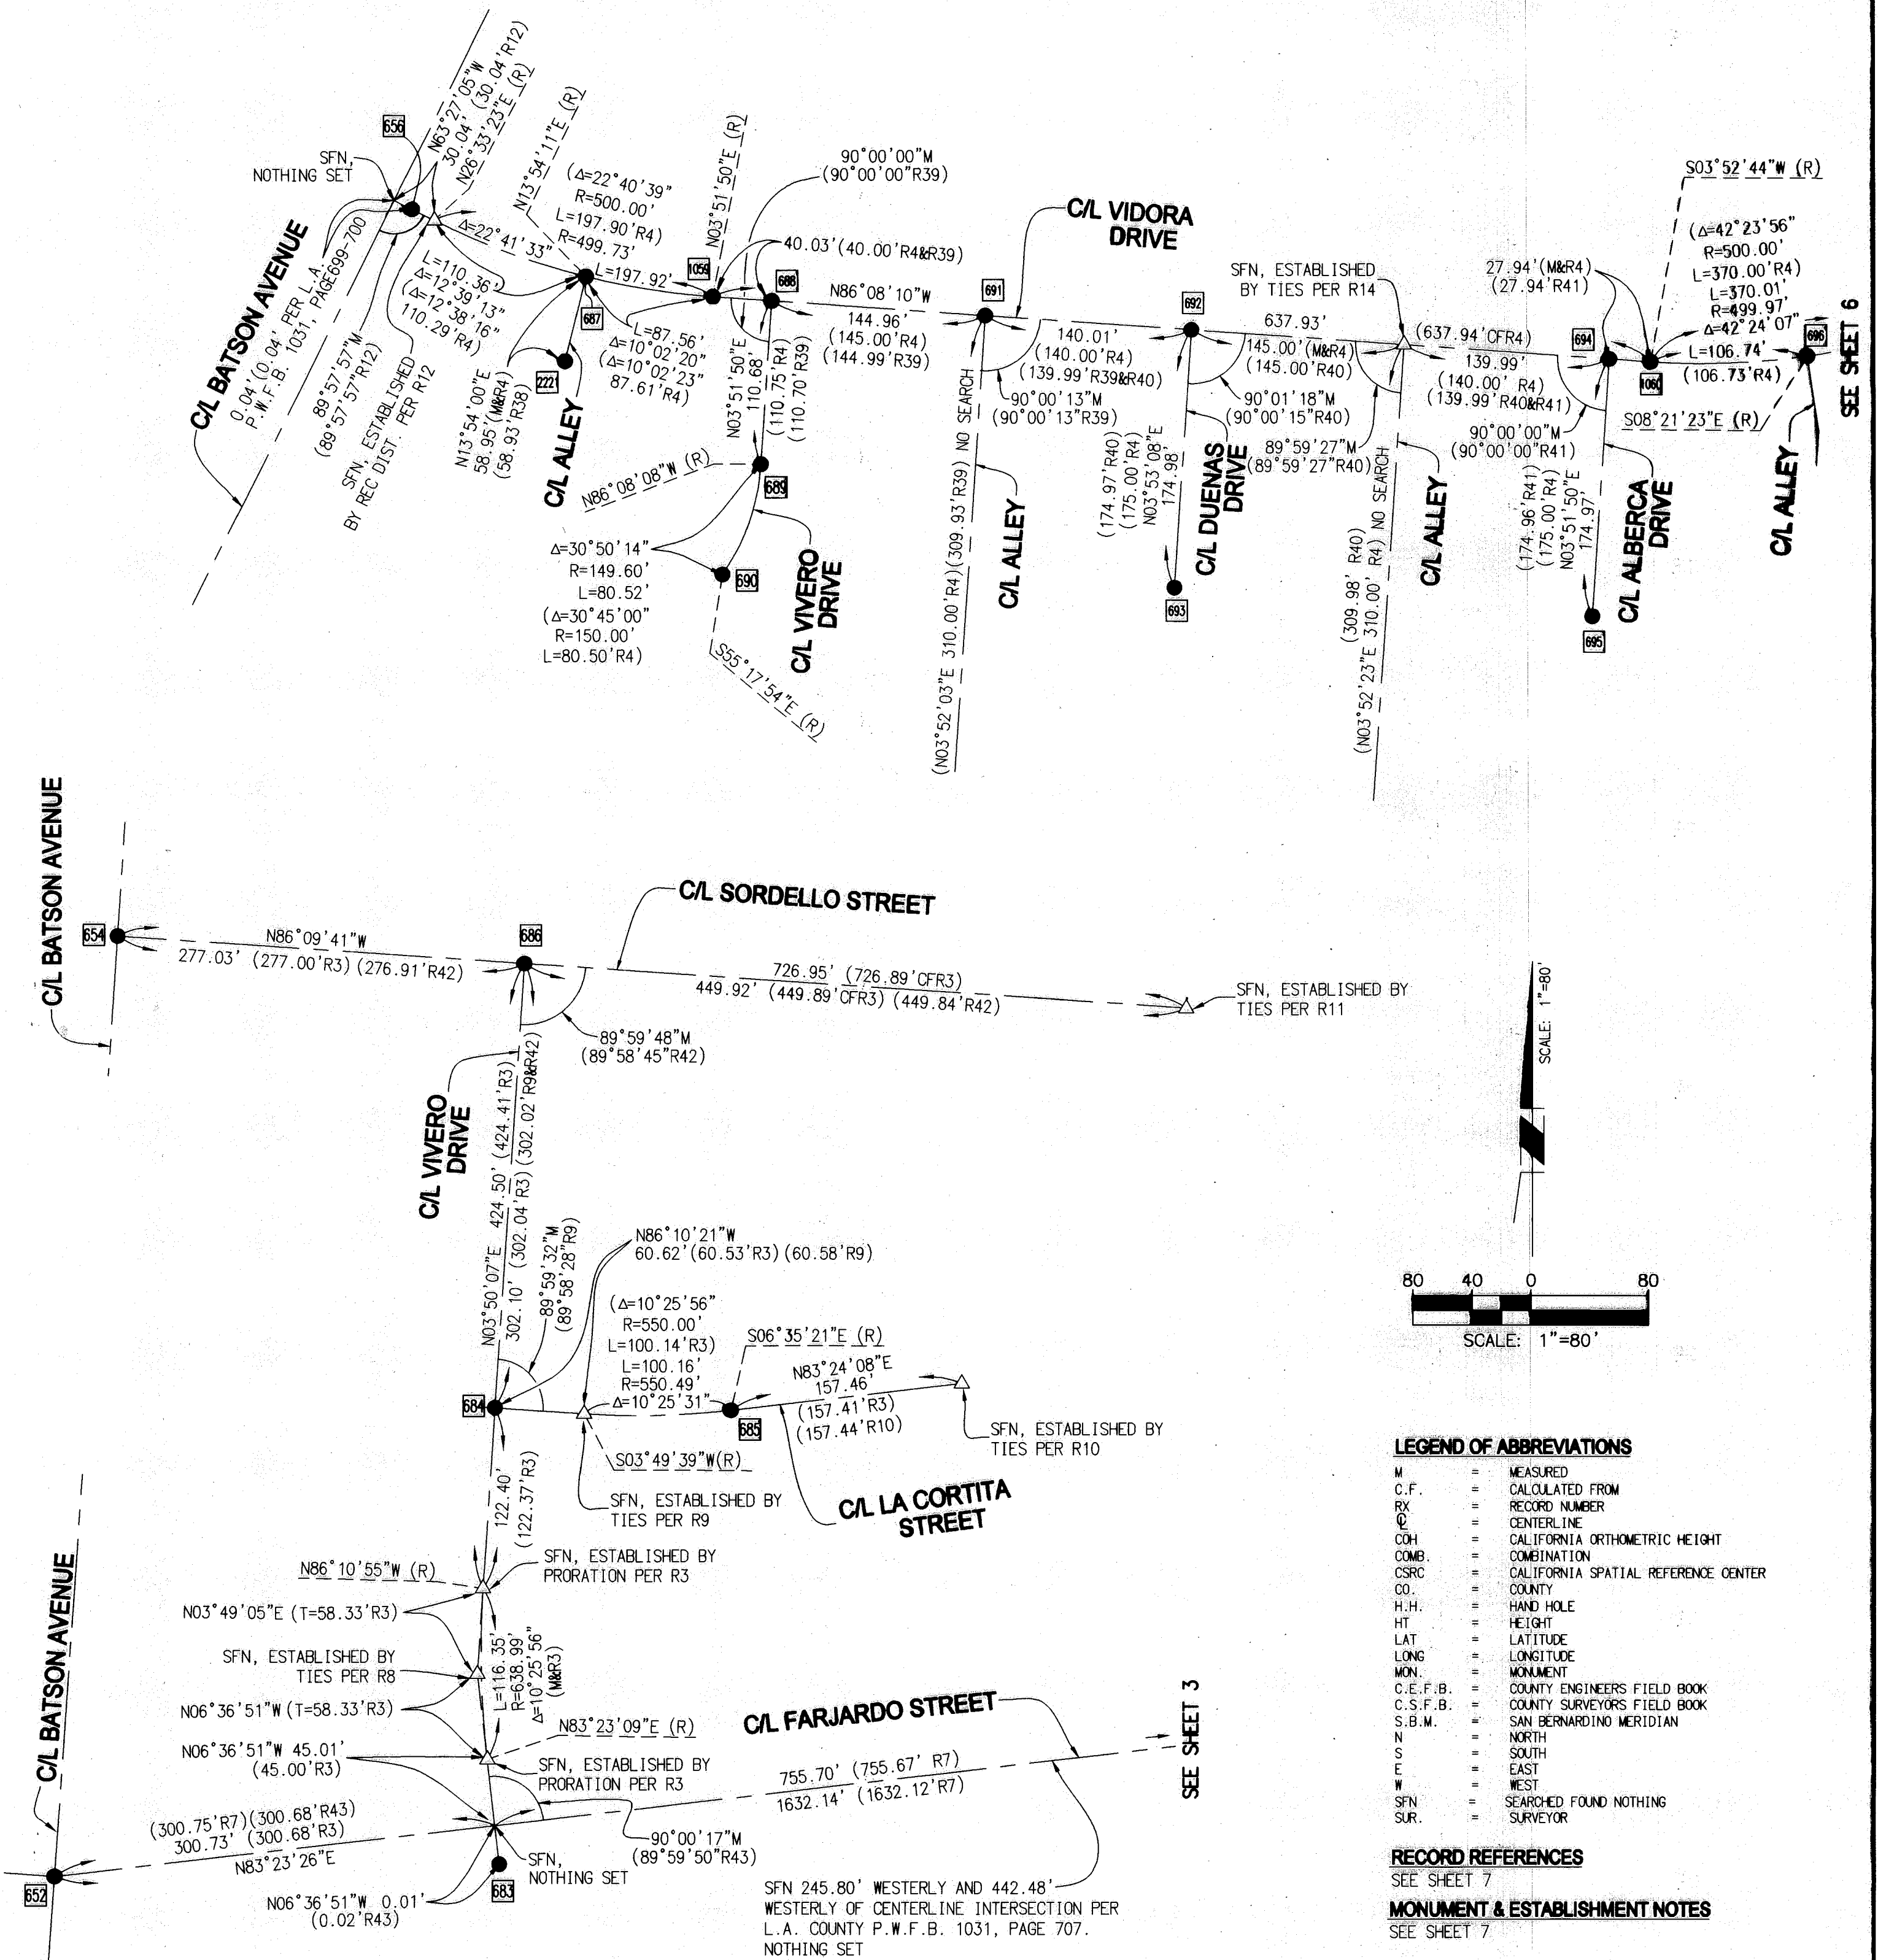INTERNATIONAL

SHEET 5 OF 7 SHEETS
SCALE: 1" = 80'

RECORD OF SURVEY

IN THE UNINCORPORATED TERRITORY OF THE
COUNTY OF LOS ANGELES, STATE OF CALIFORNIA

BEING A SURVEY OF THE CENTERLINES OF VIDORA DRIVE, VIVERO DRIVE, DUENAS DRIVE, ALBERCA DRIVE, LA CUEVA DRIVE, SORDELLO STREET, LA CORTITA STREET, FARJARD STREET, BELLORITA STREET, VILLA CLARA STREET, DOUBLETREE LANE, LOS PADRES DRIVE, SIERRA LEONE AVENUE, CAMARINA DRIVE, GALATINA STREET, Mescalero STREET, & CANELA PLACE

LAWRENCE L. TRUMAN, PLS 5346

Michael Baker
INTERNATIONAL

DATE OF SURVEY: AUGUST, 2022

LEGEND OF ABBREVIATIONS



M	=	MEASURED
C.F.	=	CALCULATED FROM
RX	=	RECORD NUMBER
C	=	CENTERLINE
COH	=	CALIFORNIA ORTHOMETRIC HEIGHT
COMB.	=	COMBINATION
CSRC	=	CALIFORNIA SPATIAL REFERENCE CENTER
CO.	=	COUNTY
H.H.	=	HAND HOLE
HT	=	HEIGHT
LAT	=	LATITUDE
LONG	=	LONGITUDE
MON.	=	MONUMENT
C.E.F.B.	=	COUNTY ENGINEERS FIELD BOOK
C.S.F.B.	=	COUNTY SURVEYORS FIELD BOOK
S.B.M.	=	SAN BERNARDINO MERIDIAN
N	=	NORTH
S	=	SOUTH
E	=	EAST
W	=	WEST
SFN	=	SEARCHED FOUND NOTHING
SUR.	=	SURVEYOR

RECORD REFERENCES

SEE SHEET 7

MONUMENT & ESTABLISHMENT NOTES

SEE SHEET 7

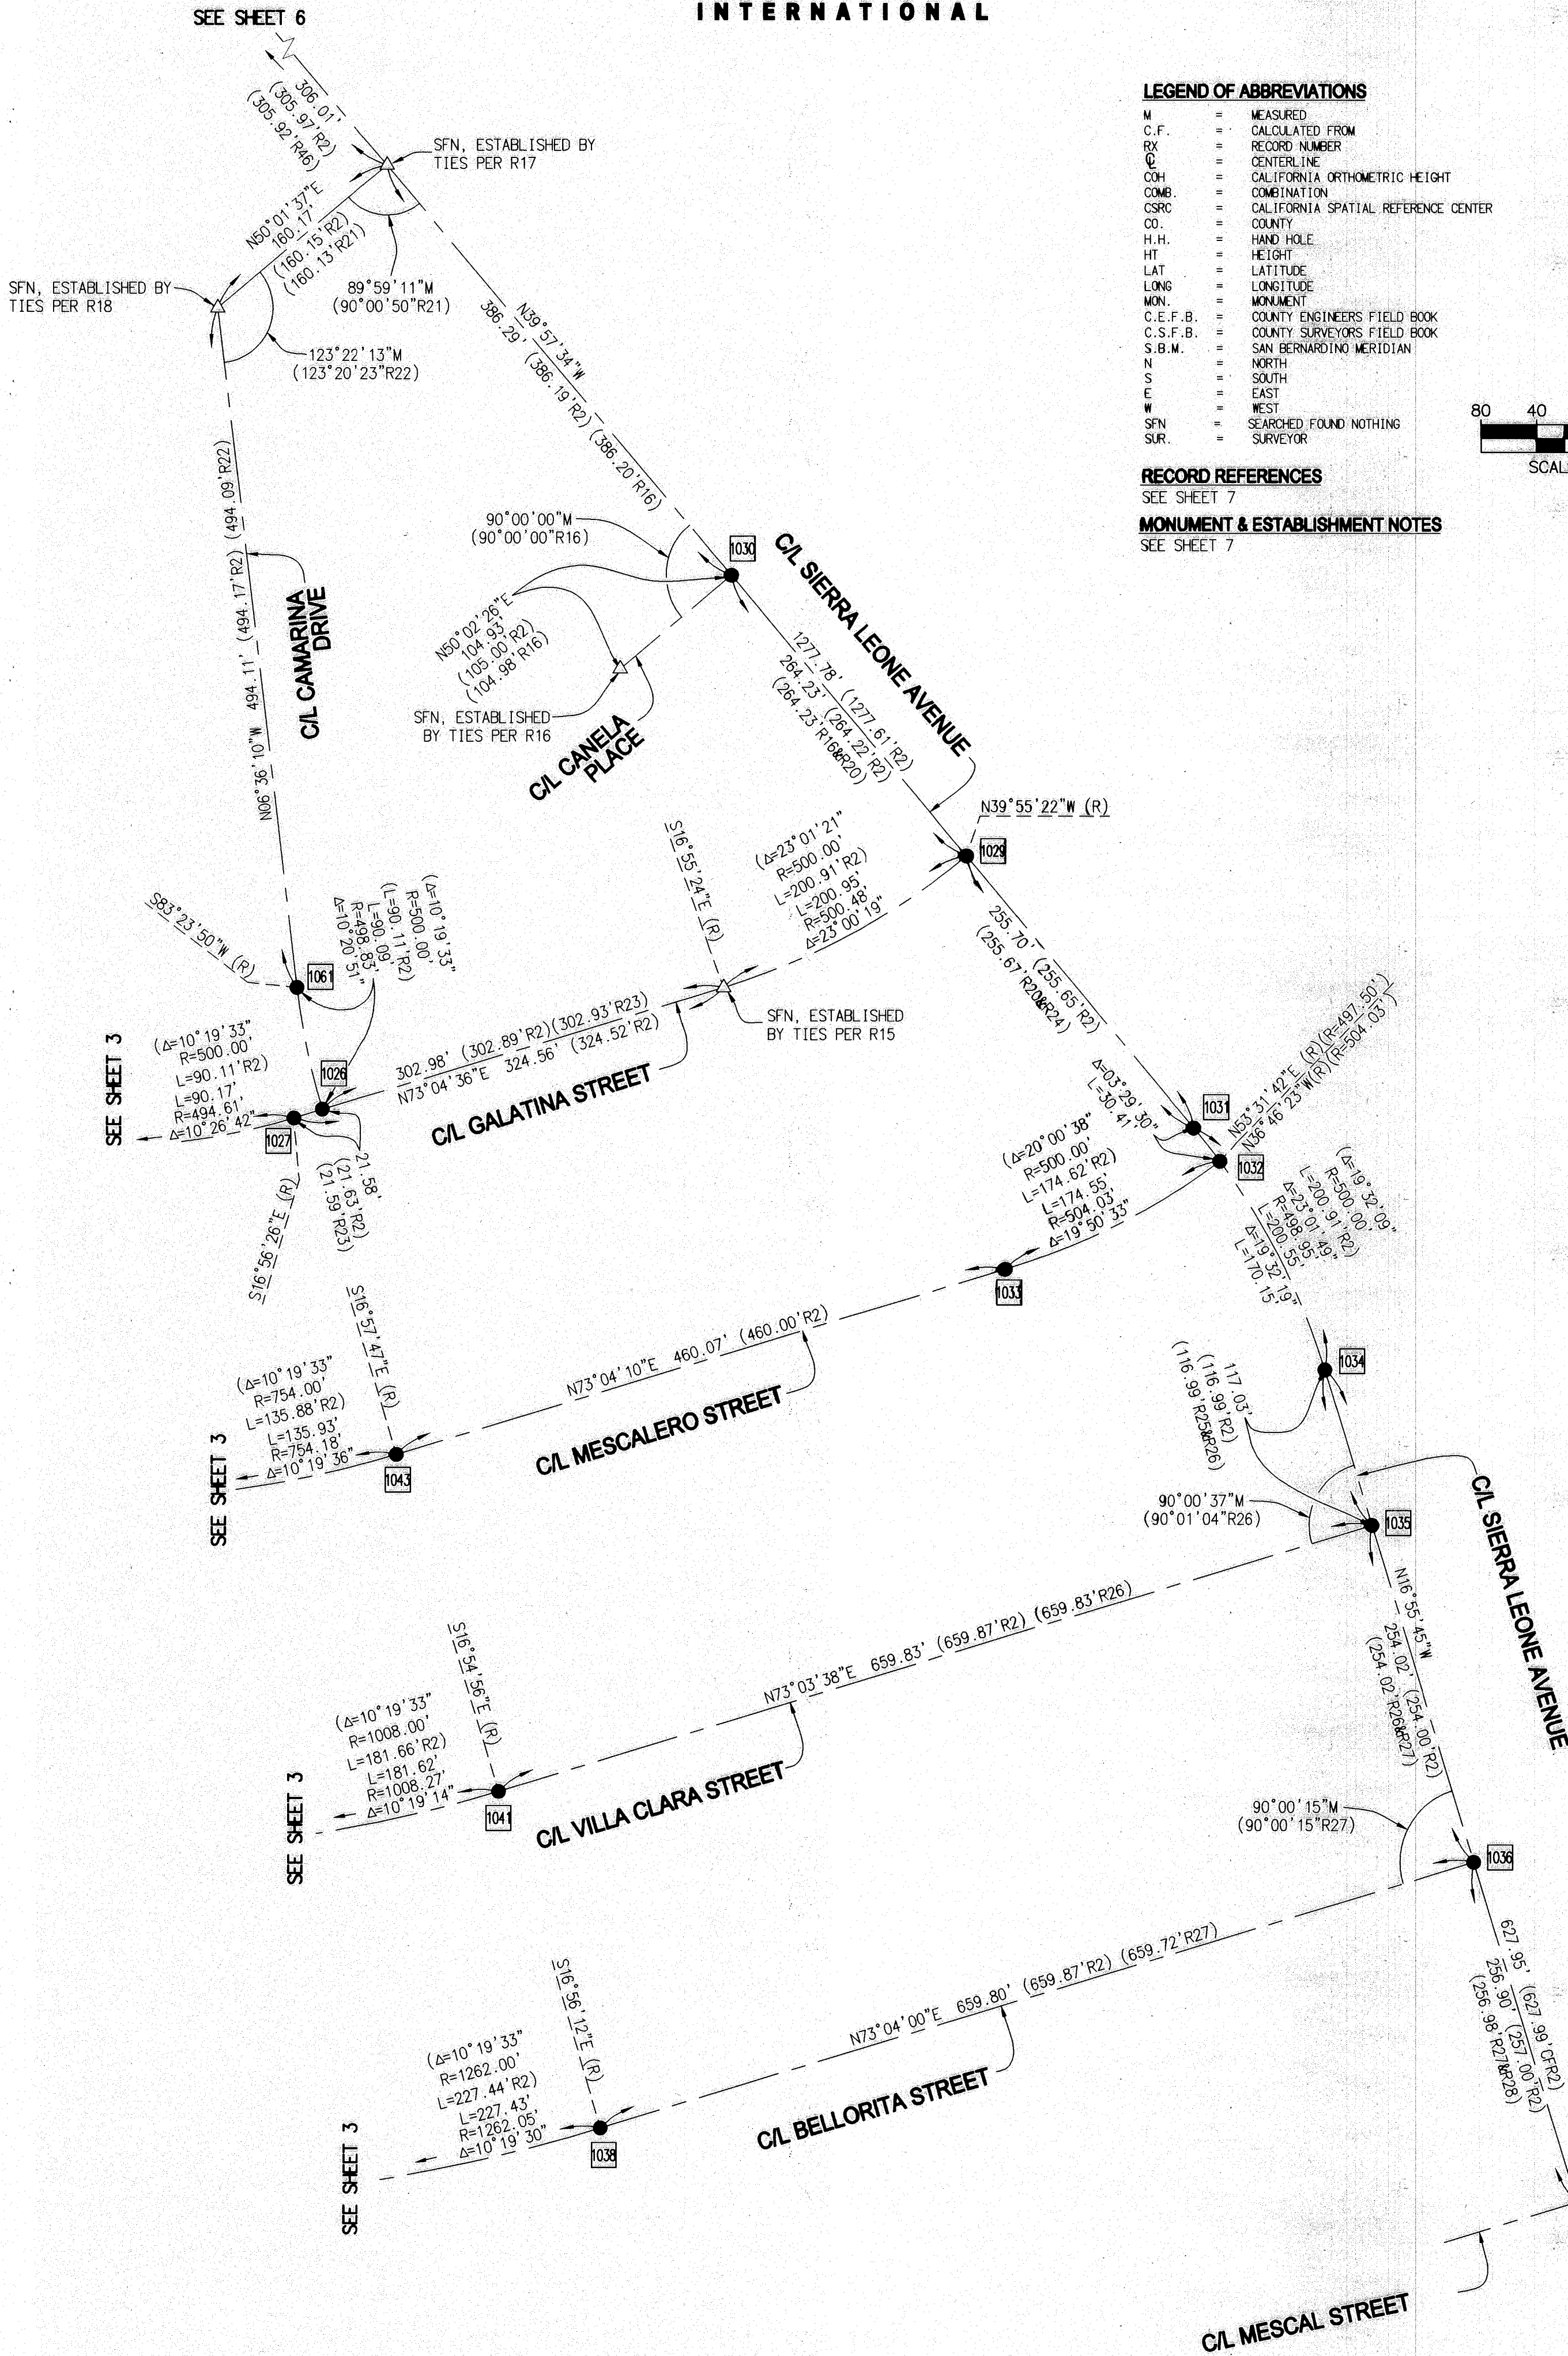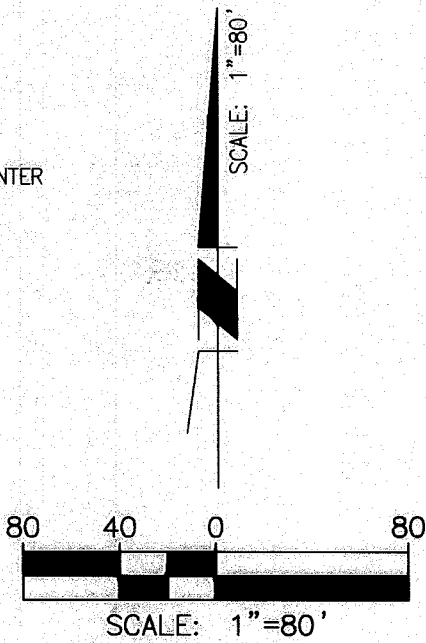

SCALE: 1" = 80'

RECORD OF SURVEY

IN THE UNINCORPORATED TERRITORY OF THE
COUNTY OF LOS ANGELES, STATE OF CALIFORNIA

BEING A SURVEY OF THE CENTERLINES OF VIDORA DRIVE, VIVERO DRIVE, DUENAS DRIVE, ALBERCA DRIVE, LA CUEVA DRIVE, SORDELLO STREET, LA OORTITA STREET, FARJADO STREET, BELLORITA STREET, VILLA CLARA STREET, DOUBLETREE LANE, LOS PADRES DRIVE, SIERRA LEONE AVENUE, CAMARITA DRIVE, GALATINA STREET, MESCALERO STREET, & CANELA PLACE

LAWRENCE L. TRUMAN, PLS 5346

Michael Baker

DATE OF SURVEY: AUGUST, 2022

INTERNATIONAL

LEGEND OF ABBREVIATIONS



M	MEASURED
C.F.	CALCULATED FROM
RK	RECORD NUMBER
C	CENTERLINE
COH	CALIFORNIA ORTHOMETRIC HEIGHT
COMB.	COMBINATION
CSRC	CALIFORNIA SPATIAL REFERENCE CENTER
CO.	COUNTY
H.H.	HAND HOLE
HT	HEIGHT
LAT	LATITUDE
LONG	LONGITUDE
MON.	MONUMENT
C.E.F.B.	COUNTY ENGINEERS FIELD BOOK
C.S.F.B.	COUNTY SURVEYORS FIELD BOOK
S.B.M.	SAN BERNARDINO MERIDIAN
N	NORTH
S	SOUTH
E	EAST
W	WEST
SFN	SEARCHED FOUND NOTHING
SUR.	SURVEYOR

RECORD REFERENCES

SEE SHEET 7

MONUMENT & ESTABLISHMENT NOTES

SEE SHEET 7

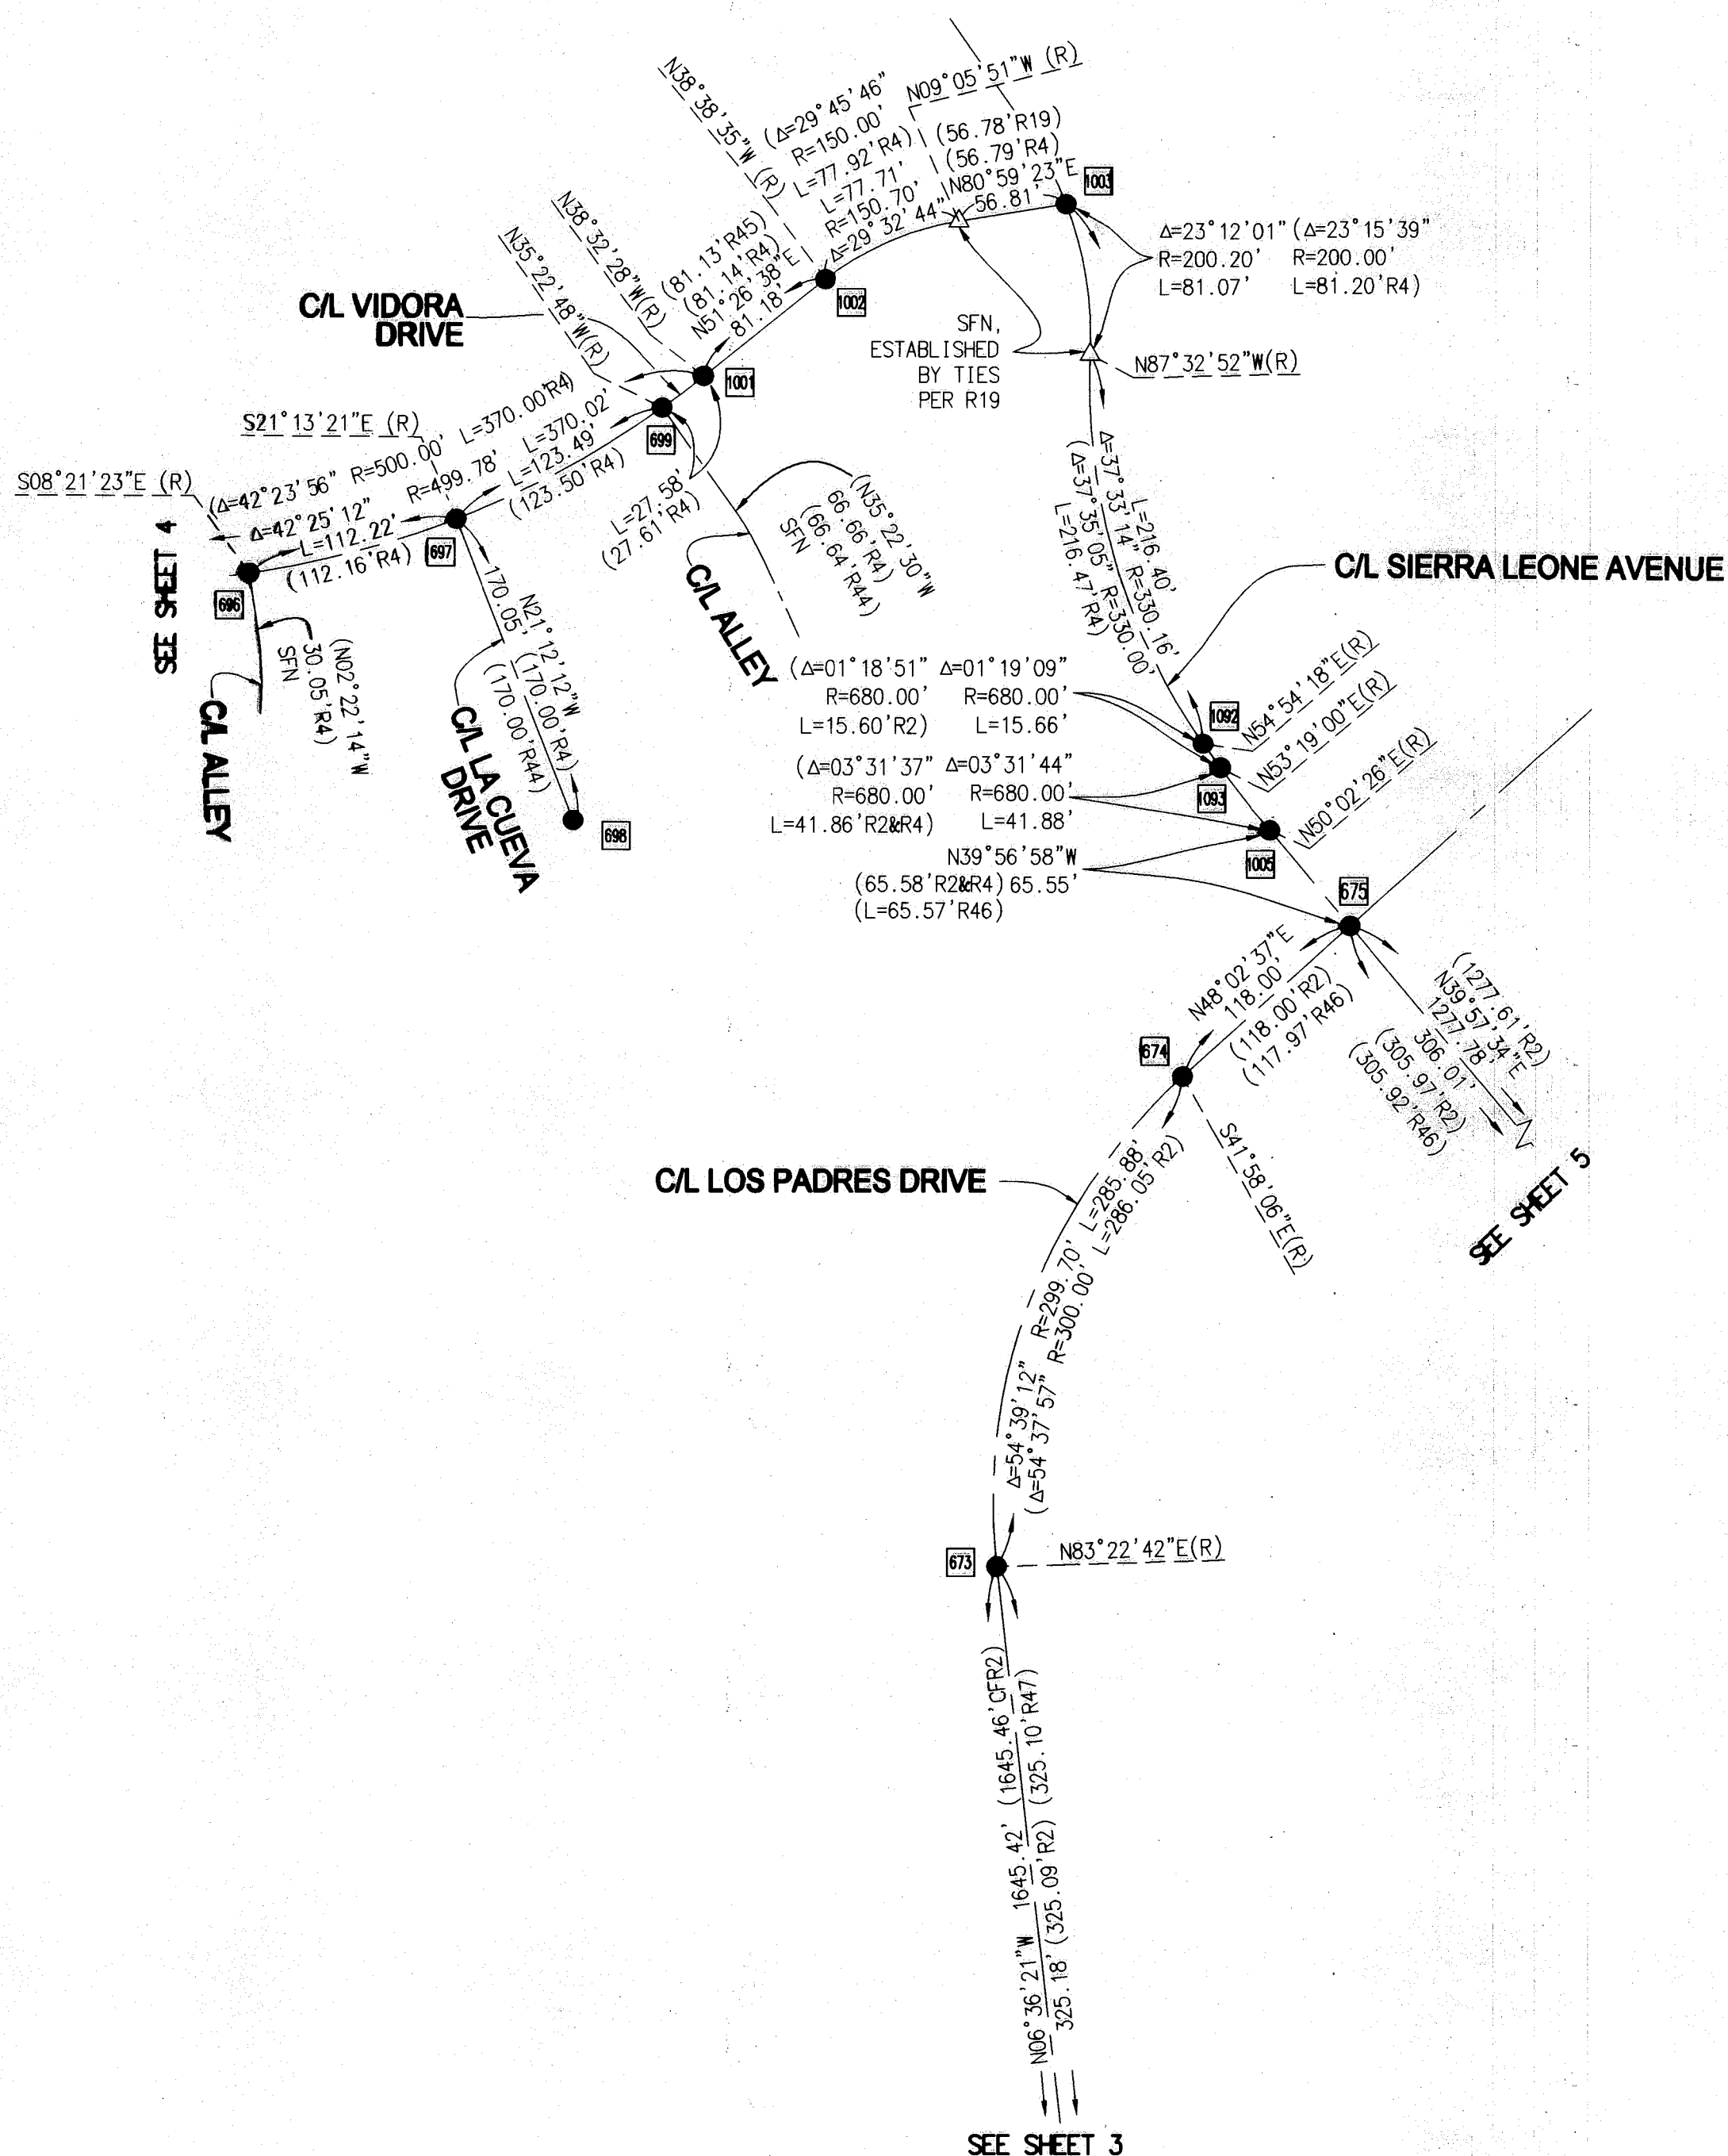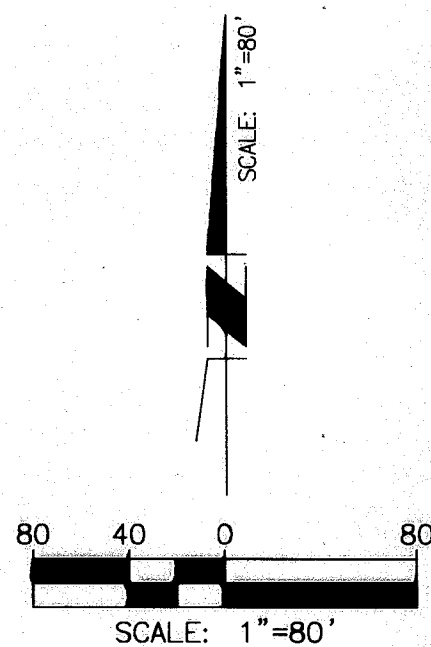

RECORD OF SURVEY
IN THE UNINCORPORATED TERRITORY OF THE
COUNTY OF LOS ANGELES, STATE OF CALIFORNIA

LAWRENCE L. TRUMAN, PLS 5346

Michael Baker

DATE OF SURVEY: AUGUST, 2022

INTERNATIONAL

MONUMENT & ESTABLISHMENT NOTES

- INDICATES FOUND CENTERLINE MONUMENT AS NOTED AND REFERENCED.
- △ INDICATES SET SPIKE & WASHER STAMPED "LS 5346", FLUSH.
- 652 FOUND STD LACO RD SPIKE & WASHER, IN WELL, DN. 0.5', PER L.A. COUNTY R.D.F.B. 1031, PAGE 286A.
- 654 FOUND BOAT SPIKE & TAG, ILLEGIBLE, DN. 0.3', ACCEPTED AS S&T PER L.A. COUNTY P.W.F.B. 1031, PAGE 294C.
- 656 FOUND ROUND HEAD SPIKE & TAG, DN. 0.4', ACCEPTED AS S&T PER R4.
- 661 FOUND ROUND HEAD SPIKE & TAG, STAMPED "RCE 24226", FLUSH, PER R6.
- 662 FOUND ROUND HEAD SPIKE & TAG, STAMPED "RCE 24226", DN. 0.3', PER R6.
- 663 FOUND ROUND HEAD SPIKE & TAG STAMPED "LS 2495", DN. 0.1', PER R1.
- 664 FOUND BOAT SPIKE & TAG STAMPED "LS 2495", DN. 0.1' PER R37.
- 665 FOUND SPIKE & TAG STAMPED "LS 2495", DN. 0.1', PER L.A. COUNTY P.W.F.B. 1031, PAGE 838.
- 666 FOUND ROUND HEAD SPIKE & TAG STAMPED "LS 2495", DN. 0.1', PER L.A. COUNTY P.W.F.B. 1031, PAGE 836.
- 667 FOUND ROUND HEAD SPIKE & TAG, ILLEGIBLE, DN. 0.3', ACCEPTED AS S&T PER R29.
- 668 FOUND ROUND HEAD SPIKE & TAG, ILLEGIBLE, DN. 0.3', ACCEPTED AS S&T PER R31.
- 669 FOUND ROUND HEAD SPIKE, DN. 0.3', ACCEPTED AS S&T PER R32.
- 670 FOUND ROUND HEAD SPIKE, DN. 0.3', ACCEPTED AS S&T PER R33.
- 671 FOUND ROUND HEAD SPIKE, DN. 0.3', ACCEPTED AS S&T PER R34.
- 672 FOUND ROUND HEAD SPIKE, DN. 0.3', ACCEPTED AS S&T PER L.A. COUNTY R.D.F.B. 1031, PAGE 290.
- 673 FOUND ROUND HEAD SPIKE, DN. 0.3', ACCEPTED AS S&T PER R47.
- 674 FOUND ROUND HEAD SPIKE, DN. 0.3', ACCEPTED AS S&T PER L.A. COUNTY P.W.F.B. 1031, PAGE 727.
- 675 FOUND ROUND HEAD SPIKE, DN. 0.3', ACCEPTED AS S&T PER R46.
- 683 FOUND ROAD DEPT. SPIKE & TAG, ILLEGIBLE, DN. 0.2', ACCEPTED AS S&T PER L.A. COUNTY R.D.F.B. 1031, PAGE 287B.
- 684 FOUND BOAT SPIKE & TAG, ILLEGIBLE, FLUSH, ACCEPTED AS S&T PER R9.
- 685 FOUND ROUND HEAD SPIKE, DN. 0.3', ACCEPTED AS S&T PER R10.
- 686 FOUND ROUND HEAD SPIKE & TAG, ILLEGIBLE, DN. 0.2', ACCEPTED AS S&T PER R42.
- 687 FOUND ROUND HEAD SPIKE & TAG, ILLEGIBLE, DN. 0.3', ACCEPTED AS S&T PER R14.
- 688 FOUND ROUND HEAD SPIKE & TAG, ILLEGIBLE, DN. 0.2', ACCEPTED AS S&T PER R39.
- 689 FOUND ROUND HEAD SPIKE, DN. 0.1', ACCEPTED AS S&T PER L.A. COUNTY P.W.F.B. 1031, PAGE 715.
- 690 FOUND ROUND HEAD SPIKE, DN. 0.1', ACCEPTED AS S&T PER L.A. COUNTY P.W.F.B. 1031, PAGE 715.
- 691 FOUND ROUND HEAD SPIKE & TAG, ILLEGIBLE, DN. 0.1', ACCEPTED AS S&T PER R39.
- 692 FOUND ROUND HEAD SPIKE & TAG, ILLEGIBLE, DN. 0.3', ACCEPTED AS S&T PER R40.
- 693 FOUND ROUND SPIKE, DN. 0.3', ACCEPTED AS S&T PER L.A. COUNTY P.W.F.B. 1031, PAGE 716.
- 694 FOUND ROUND HEAD SPIKE & TAG, ILLEGIBLE, DN. 0.3', ACCEPTED AS S&T PER R41.
- 695 FOUND ROUND HEAD SPIKE, DN. 0.3', ACCEPTED AS S&T PER L.A. COUNTY P.W.F.B. 1031, PAGE 717.
- 696 FOUND ROUND HEAD SPIKE & TAG, ILLEGIBLE, DN. 0.3', ACCEPTED AS S&T PER R41.
- 697 FOUND ROUND HEAD SPIKE & TAG, ILLEGIBLE, DN. 0.3', ACCEPTED AS S&T PER R44.
- 698 FOUND ROUND HEAD SPIKE, DN. 0.3', ACCEPTED AS S&T PER L.A. COUNTY P.W.F.B. 1031, PAGE 718.
- 699 FOUND ROUND HEAD SPIKE, DN. 0.3', ACCEPTED AS S&T PER R44.
- 1001 FOUND ROUND HEAD SPIKE, DN. 0.3', ACCEPTED AS S&T PER R45.
- 1002 FOUND ROUND HEAD SPIKE, DN. 0.3', ACCEPTED AS S&T PER R45.
- 1003 FOUND ROUND HEAD SPIKE, DN. 0.1', ACCEPTED AS S&T PER R19.
- 1005 FOUND ROUND HEAD SPIKE, DN. 0.1', ACCEPTED AS S&T PER L.A. COUNTY P.W.F.B. 1031, PAGE 725.
- 1026 FOUND ROUND HEAD SPIKE, DN. 0.1', ACCEPTED AS S&T PER R23.
- 1027 FOUND ROUND HEAD SPIKE AND TAG, ILLEGIBLE, DN. 0.1', ACCEPTED AS S&T PER R23.
- 1028 FOUND ROUND HEAD SPIKE, DN. 0.3', ACCEPTED AS S&T PER R34.
- 1029 FOUND ROUND HEAD SPIKE, DN. 0.1', ACCEPTED AS S&T PER R20.
- 1030 FOUND ROUND HEAD SPIKE, DN. 0.1', ACCEPTED AS S&T PER R16.
- 1031 FOUND ROUND HEAD SPIKE AND TAG, ILLEGIBLE, FLUSH, ACCEPTED AS S&T PER R24.
- 1032 FOUND ROUND HEAD SPIKE AND TAG, ILLEGIBLE, FLUSH, ACCEPTED AS S&T PER R24.
- 1033 FOUND ROUND HEAD SPIKE AND TAG, ILLEGIBLE, FLUSH, ACCEPTED AS S&T PER L.A. COUNTY P.W.F.B. 1031, PAGE 825,826.
- 1034 FOUND SPIKE, DN. 0.2', ACCEPTED AS S&T PER R25.
- 1035 FOUND ROUND HEAD SPIKE AND TAG, ILLEGIBLE, DN. 0.2', ACCEPTED AS S&T PER R26.
- 1036 FOUND ROUND HEAD SPIKE, DN. 0.1', ACCEPTED AS S&T PER R27.
- 1037 FOUND ROUND HEAD SPIKE AND TAG, ILLEGIBLE, DN. 0.3', ACCEPTED AS S&T PER R28.
- 1038 FOUND ROUND HEAD SPIKE AND TAG, ILLEGIBLE, FLUSH, ACCEPTED AS S&T PER L.A. COUNTY P.W.F.B. 1031, PAGE 823.
- 1039 FOUND ROUND HEAD SPIKE AND TAG, ILLEGIBLE, DN. 0.1', ACCEPTED AS S&T PER R31.
- 1040 FOUND ROUND HEAD SPIKE AND TAG, ILLEGIBLE, FLUSH, ACCEPTED AS S&T PER R32.
- 1041 FOUND ROUND HEAD SPIKE, DN. 0.2', ACCEPTED AS S&T PER L.A. COUNTY P.W.F.B. 1031, PAGE 824.

MONUMENT & ESTABLISHMENT NOTES (CONTINUED)

- 1042 FOUND ROUND HEAD SPIKE AND TAG, ILLEGIBLE, DN. 0.1', ACCEPTED AS S&T PER R33.
- 1043 FOUND ROUND HEAD SPIKE AND TAG, ILLEGIBLE, DN. 0.2', ACCEPTED AS S&T PER L.A. COUNTY P.W.F.B. 1031, PAGE 825,826.
- 1059 FOUND ROUND HEAD SPIKE AND TAG, ILLEGIBLE, DN. 0.2', ACCEPTED AS S&T PER R39.
- 1060 FOUND ROUND HEAD SPIKE AND TAG, ILLEGIBLE, DN. 0.3', ACCEPTED AS S&T PER R41.
- 1061 FOUND ROUND HEAD SPIKE, DN. 0.2', ACCEPTED AS S&T PER R23.
- 1092 FOUND ROUND HEAD SPIKE AND TAG, ILLEGIBLE, DN. 0.1', ACCEPTED AS S&T PER L.A. COUNTY P.W.F.B. 1031, PAGE 725.
- 1093 FOUND ROUND HEAD SPIKE, DN. 0.2', ACCEPTED AS S&T PER L.A. COUNTY P.W.F.B. 1031, PAGE 725.
- 1094 FOUND ROUND HEAD SPIKE & WASHER STAMPED "LS 9246", FLUSH, PER R7.
- 2221 FOUND LEAD AND TACK STAMPED "LS 2631", FLUSH IN CONCRETE GUTTER PER R14.

RECORD REFERENCES

(R#) INDICATES RECORD DATA AS NOTED.

- R1 = TRACT NO. 30110, M.B. 743/91-92 (TRACT TIES C.E.F.B. 3073/64-69)
- R2 = TRACT NO. 25271, M.B. 651/86-96 (TRACT TIES C.E.F.B. 3021/26-55)
- R3 = TRACT NO. 26585, M.B. 689/7-8 (TRACT TIES C.E.F.B. 3032/69-76)
- R4 = TRACT NO. 25612, M.B. 666/41-44 (TRACT TIES C.E.F.B. 3021/73-83)
- R5 = TRACT NO. 25120, M.B. 652/15-17 (TRACT TIES C.E.F.B. 3008/69-72)
- R6 = L.A. COUNTY P.W.F.B. 1031, PAGE 1488
- R7 = L.A. COUNTY R.O.S. BOOK 308, PAGE 8
- R8 = L.A. COUNTY P.W.F.B. 1031, PAGE 706 (C.E.F.B. 2724/133)
- R9 = L.A. COUNTY P.W.F.B. 1031, PAGE 704 (C.E.F.B. 2724/131)
- R10 = L.A. COUNTY P.W.F.B. 1031, PAGE 705 (C.E.F.B. 2724/132)
- R11 = L.A. COUNTY P.W.F.B. 1031, PAGE 703 (C.E.F.B. 2724/130)
- R12 = L.A. COUNTY P.W.F.B. 1031, PAGE 699A-700A (C.E.F.B. 2724/128)
- R13 = L.A. COUNTY P.W.F.B. 1031, PAGE 710 (C.E.F.B. 2724/137)
- R14 = L.A. COUNTY P.W.F.B. 1031, PAGE 708 (C.E.F.B. 2724/135)
- R15 = L.A. COUNTY P.W.F.B. 1031, PAGE 828 (C.E.F.B. 2724/234)
- R16 = L.A. COUNTY P.W.F.B. 1031, PAGE 790-791 (C.E.F.B. 2724/208)
- R17 = L.A. COUNTY P.W.F.B. 1031, PAGE 792-793 (C.E.F.B. 2724/209)
- R18 = L.A. COUNTY P.W.F.B. 1031, PAGE 794 (C.E.F.B. 2724/210)
- R19 = L.A. COUNTY P.W.F.B. 1031, PAGE 724 (C.E.F.B. 2724/149)
- R20 = L.A. COUNTY P.W.F.B. 1031, PAGE 789 (C.E.F.B. 2724, PAGE 207)
- R21 = L.A. COUNTY P.W.F.B. 1031, PAGE 792,793 (C.E.F.B. 2724, PAGE 209)
- R22 = L.A. COUNTY P.W.F.B. 1031, PAGE 794 (C.E.F.B. 2724, PAGE 210)
- R23 = L.A. COUNTY P.W.F.B. 1031, PAGE 827 (C.E.F.B.2724, PAGE 233)
- R24 = L.A. COUNTY P.W.F.B. 1031, PAGE 788 (C.E.F.B. 2724, PAGE 206)
- R25 = L.A. COUNTY P.W.F.B. 1031, PAGE 787 (C.E.F.B. 2724, PAGE 205)
- R26 = L.A. COUNTY P.W.F.B. 1031, PAGE 785,786 (C.E.F.B. 2724, PAGE 204)
- R27 = L.A. COUNTY P.W.F.B. 1031, PAGE 784 (C.E.F.B. 2724, PAGE 203)
- R28 = L.A. COUNTY P.W.F.B. 1031, PAGE 783 (C.E.F.B. 2724, PAGE 202)
- R29 = L.A. COUNTY P.W.F.B. 1031, PAGE 800 (C.E.F.B. 2724, PAGE 215)
- R30 = L.A. COUNTY P.W.F.B. 1031, PAGE 834 (C.E.F.B. 2724, PAGE 239)
- R31 = L.A. COUNTY P.W.F.B. 1031, PAGE 801 (C.E.F.B. 2724, PAGE 216)
- R32 = L.A. COUNTY P.W.F.B. 1031, PAGE 802 (C.E.F.B.2724, PAGE 217)
- R33 = L.A. COUNTY P.W.F.B. 1031, PAGE 803,804 (C.E.F.B. 2724, PAGE 218)
- R46 = L.A. COUNTY P.W.F.B. 1031, PAGE 726 (C.E.F.B. 2724, PAGE 151)
- R47 = L.A. COUNTY P.W.F.B. 1031, PAGE 808,809 (C.E.F.B. 2724, PAGE 222)